SAN JOSE SHELTER FOR THE HOMELESS

COST FREE CLARIFICATION

Maxim Schrogin
Oliver and Co.,
1035 Carleton Street,
Berkeley 94710.

CLARIFICATION no: 54
Date: 3/2/89

REGARDING WALLS, RAILINGS + PLANTER @ ~~ENRT~~ ENTRY COURT.

This clarification is issued in accordance division 1, section 1.7 of the contract specifications, for the purpose of clarifying the drawings and/or specifications. This clarification shall in no event result in an increased cost.

CONCRETE BLOCK WALLS, IRON RAILINGS, PLANTER, + WOOD FRAME + STUCCO WORK ~~SET~~ at ~~E~~ MONTGOMERY STREET ELEVATION OF ENTRY COURT SHALL BE CONSTRUCTED ACCORDING TO THE ATTACHED 2 SHEETS.

SIGNATURE

For CES

For Oliver and Company

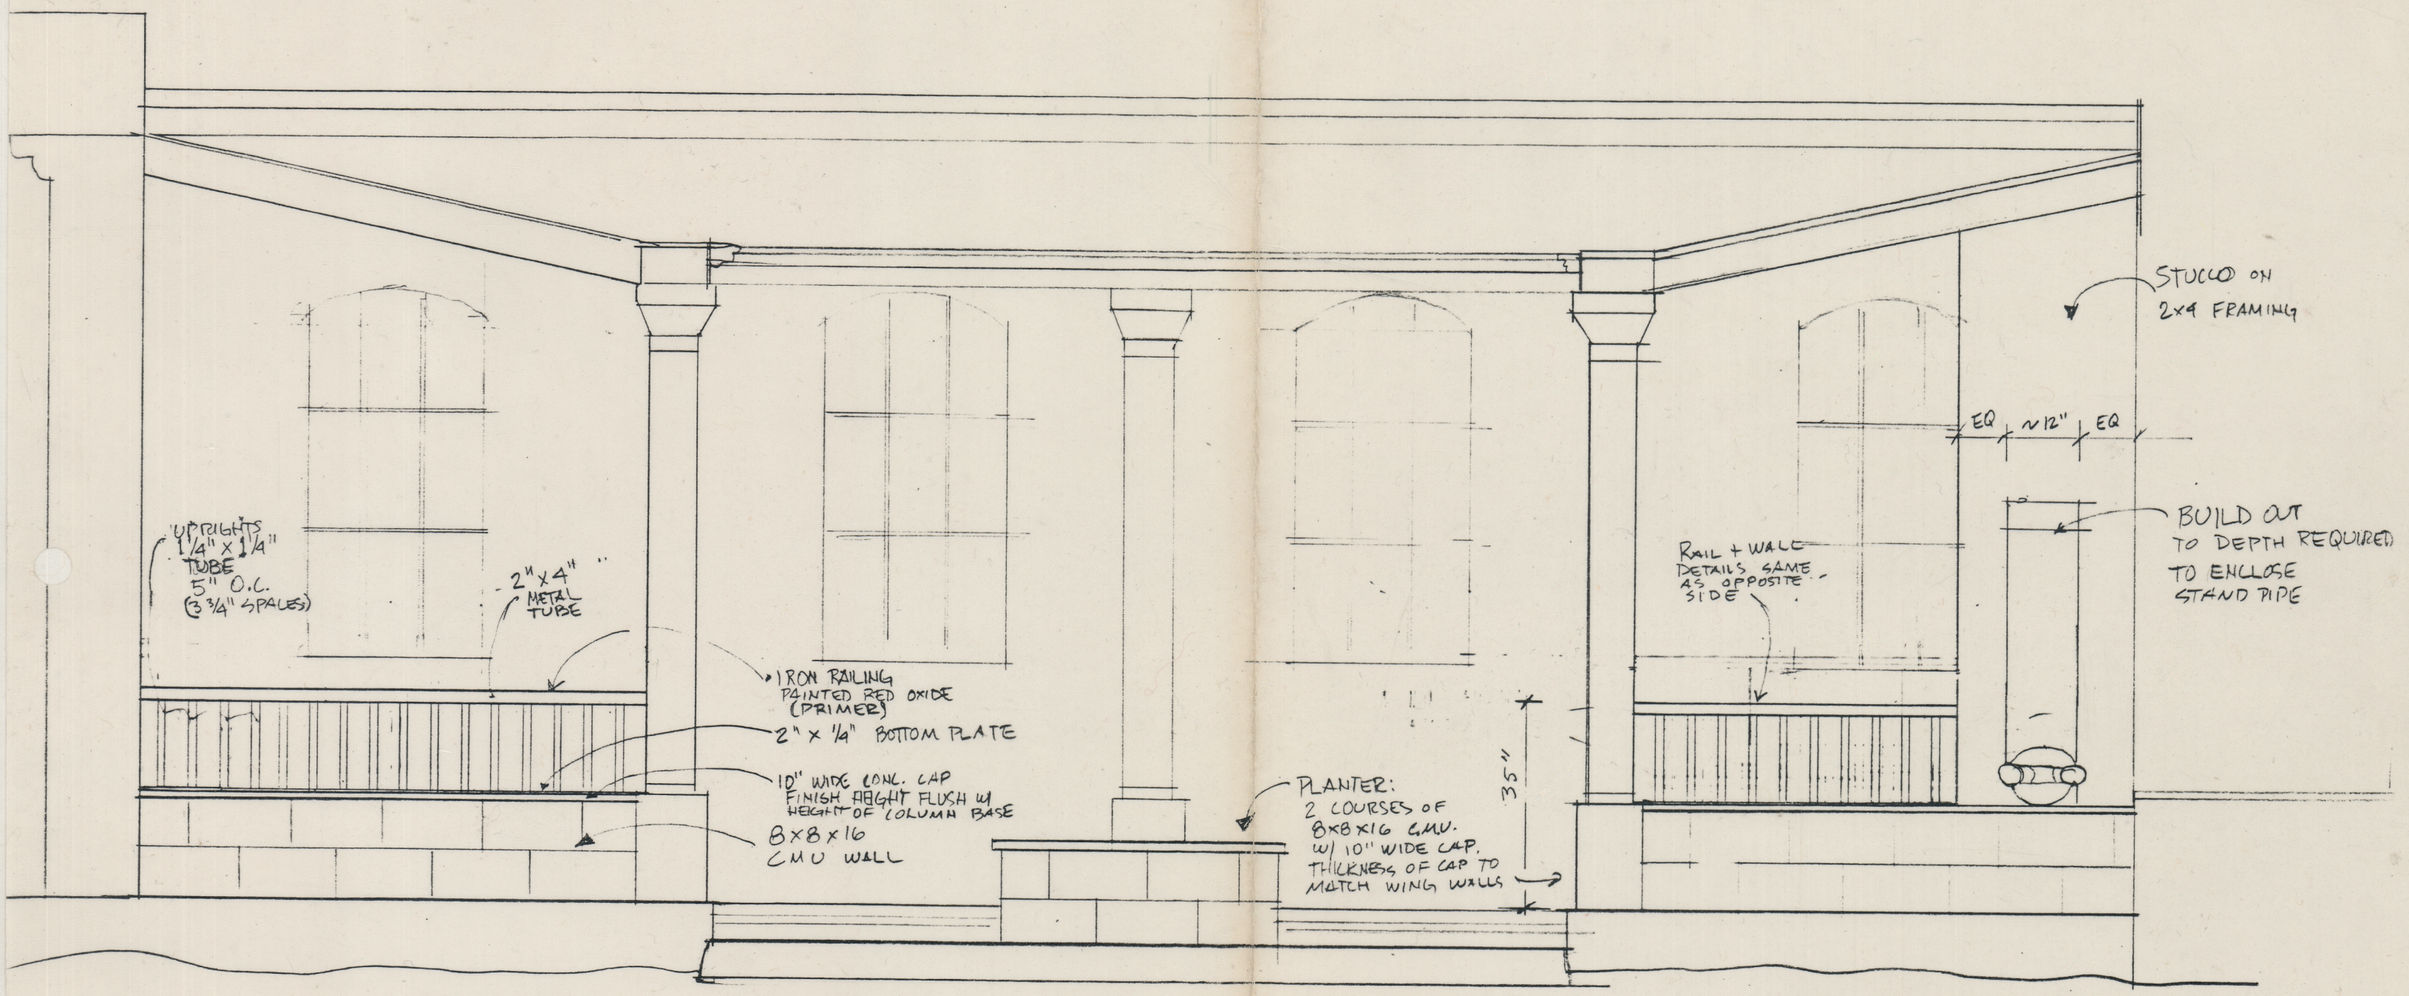

ENTRY COURT ELEVATION 1/2" = 1'

2/28/89 JM.

JULIAN ST. Inn 546 W. JULIAN ST SAN JOSE

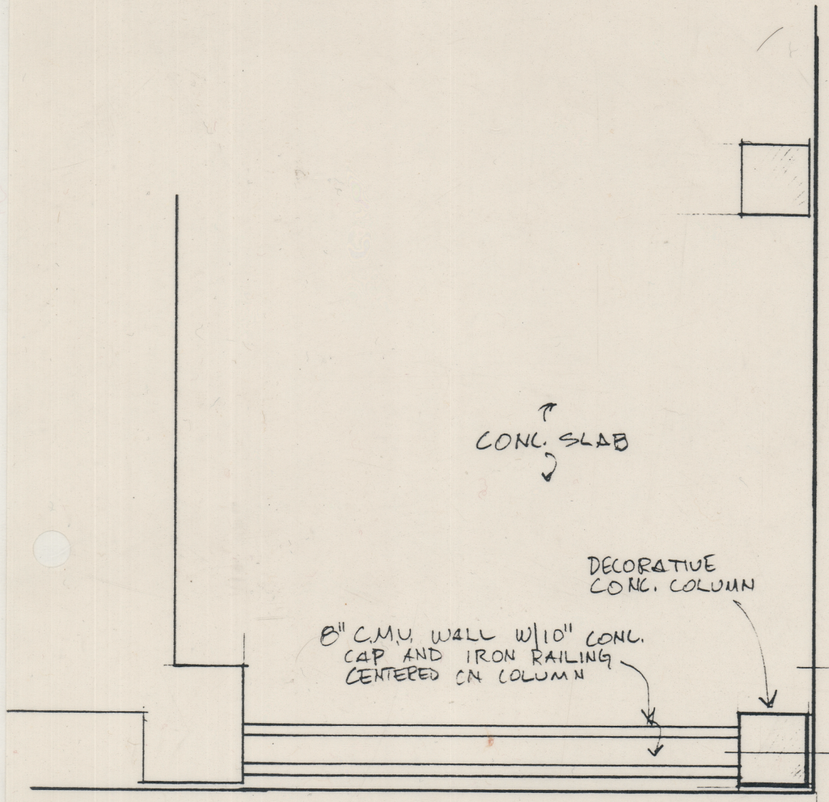

LANDSCAPING (REFER TO LANDSCAPE PLAN)

SIDEWALK

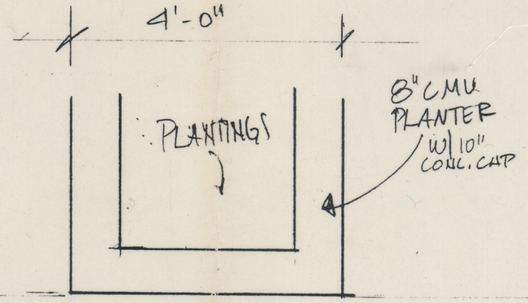

CONCRETE SIDEWALK

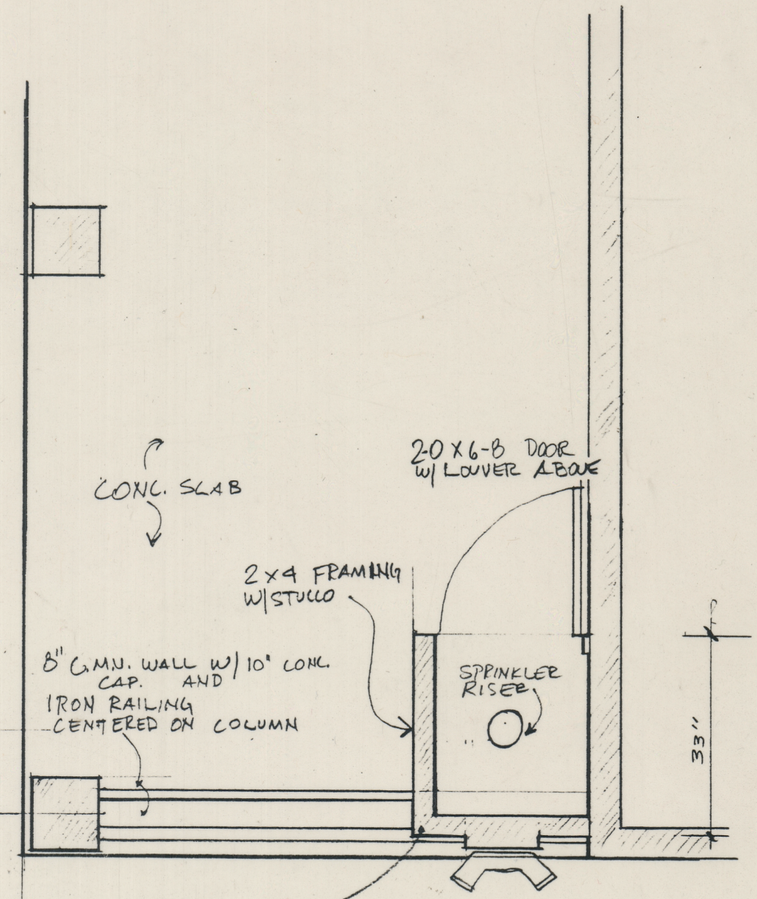

NOTE:
LOCATE WALL FACING STREET SO THAT INTERSECTION OF STUCCO + CONC. CAP IS CONSISTENT W/ SIMILAR DETAIL ON KITCHEN BLDG. ARCHITECT TO APPROVE FRAMING LAYOUT.

30"

ENTRY COURTYARD		PLAN
2/24/89	1/2" = 1'	J.M.